


BRIARWOOD CIRCLE DRIVE
WILLIAMSBURG VII
 1601 BRIARWOOD CIRCLE - ANN ARBOR, MI.

WILLIAMSBURG VII
 1601 BRIARWOOD CIRCLE - ANN ARBOR, MI.
 AVAILABLE FOR LEASE
 AS-BUILT
 APPROX. 2,045 SQ.FT.
 SUITE # 700
 3-25-2021

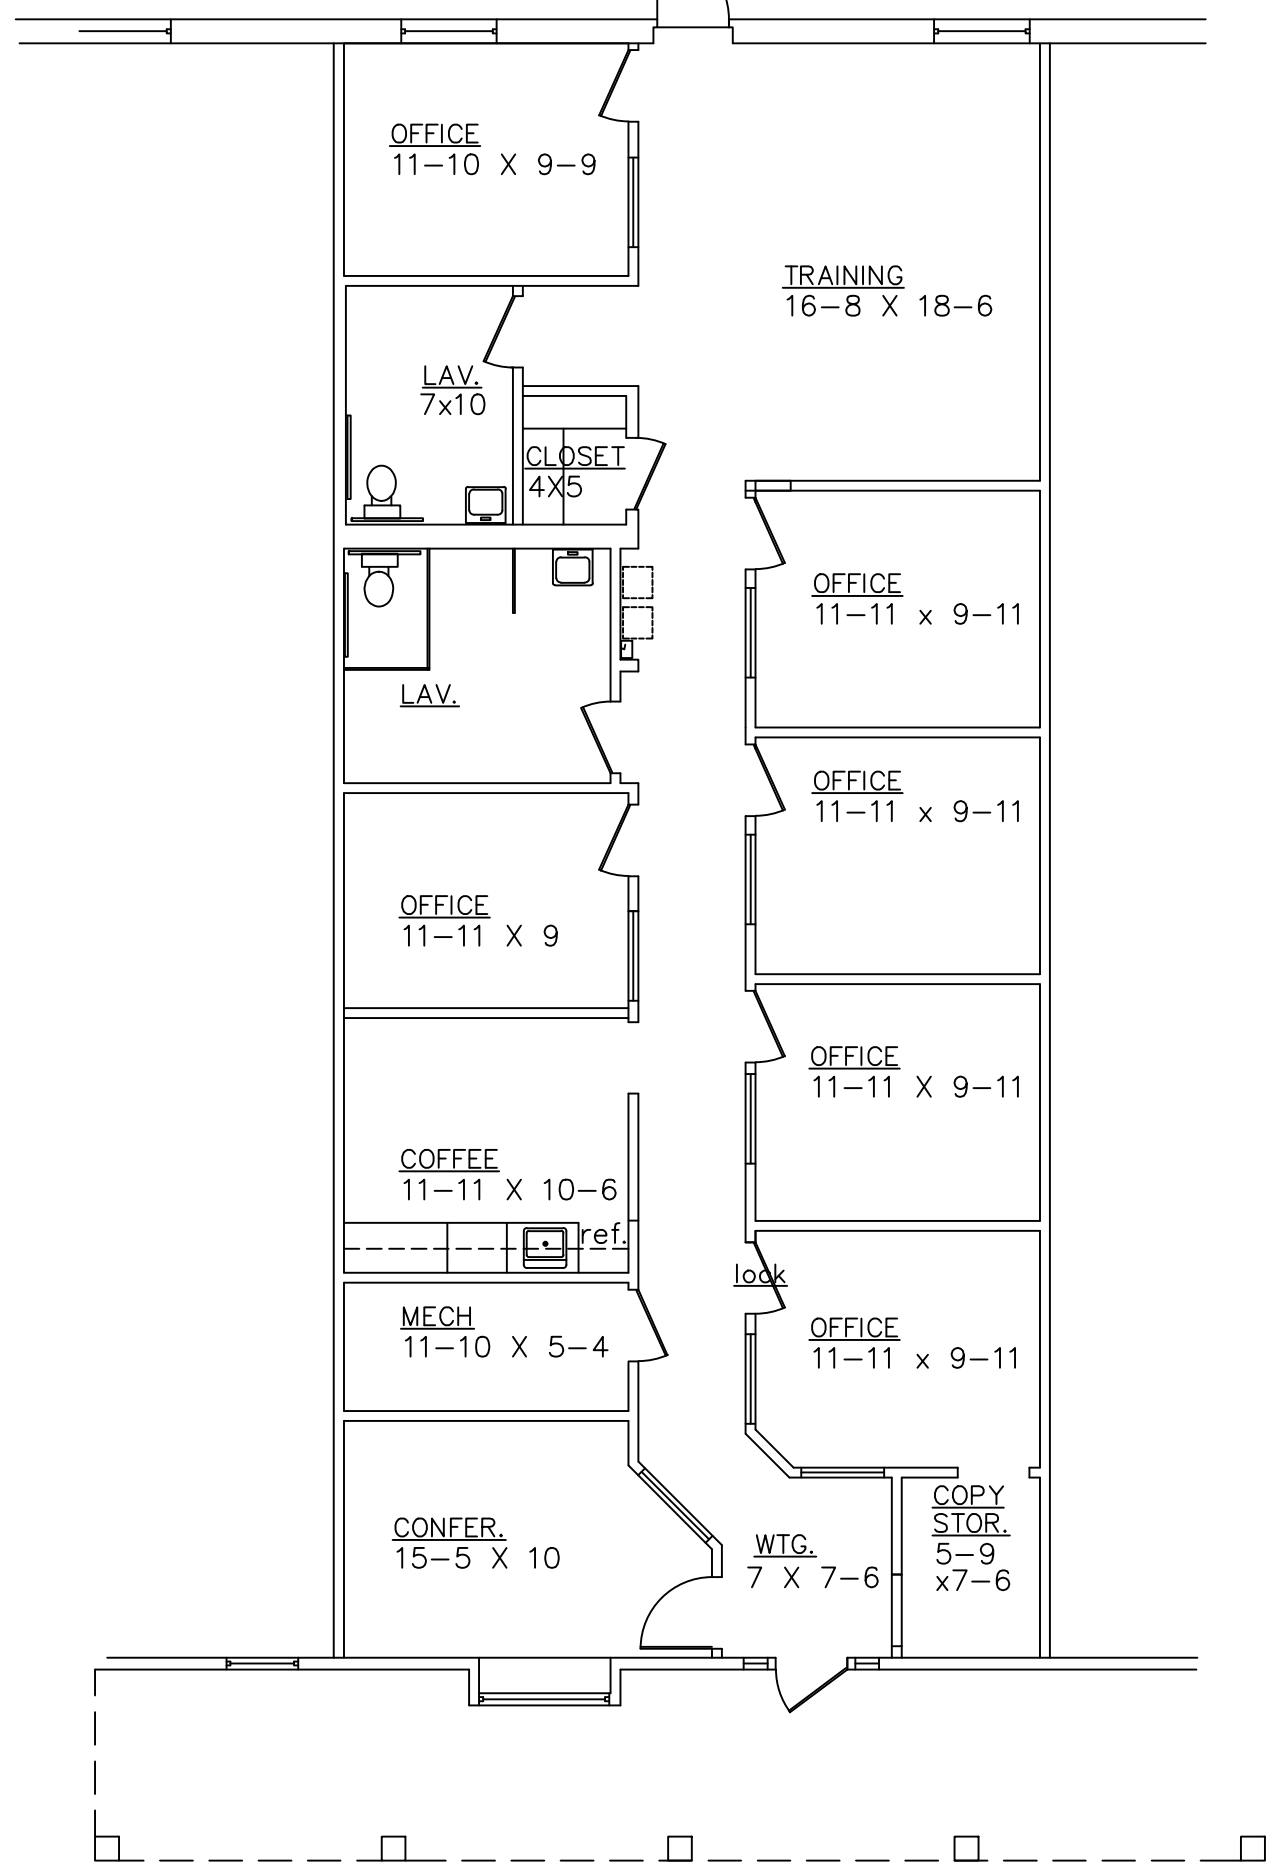

Beachum & Poeser

DEVELOPMENT & MANAGEMENT CORPORATION

CALL:
 BILL BEACHUM
 248-647-7500