

Bloomfield Hills - Governor's Place Building - 1,521 Sq. Ft



PROPERTY ADDRESS:

33 Bloomfield Hills Parkway
Suite 255
Bloomfield Hills, MI 48304

SUITE SIZE: 1,521 Sq. Ft.

AVAILABLE: June 1, 2026

FLOORPLAN: See page 2

LEASE RATE: Negotiable

LEASE TERM: 5 year term

DEMOGRAPHICS:

Oakland County, MI:

Population (2015): 1,243,970

Median household income (2015): \$67,465

Median house value (2015): \$178,900

Bloomfield Hills, MI:

Population (2015): 42,112

Median household income (2015): \$112,154

Median house value (2015): \$350,600




SUITE DESCRIPTION:

Nicely sized 2nd floor suite

Suite features:


- 4 windowed offices
- 1 non-windowed office
- Reception area
- Male and female restrooms
- Admin area, file room, kitchen

Other features include windows that open; individual control over HVAC and plenty of convenient parking just steps from building entrance.

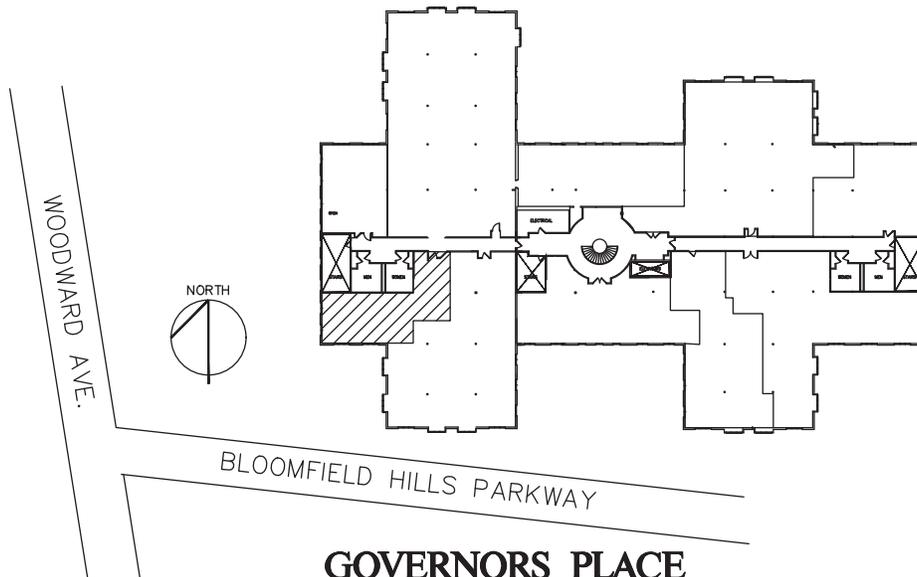

GOVERNORS PLACE

33 BLOOMFIELD HILLS PARKWAY
 BLOOMFIELD HILLS, MI.
 SUITE 255
 APPROX. 1,521 R.S.F.
 AS-BUILT PLAN

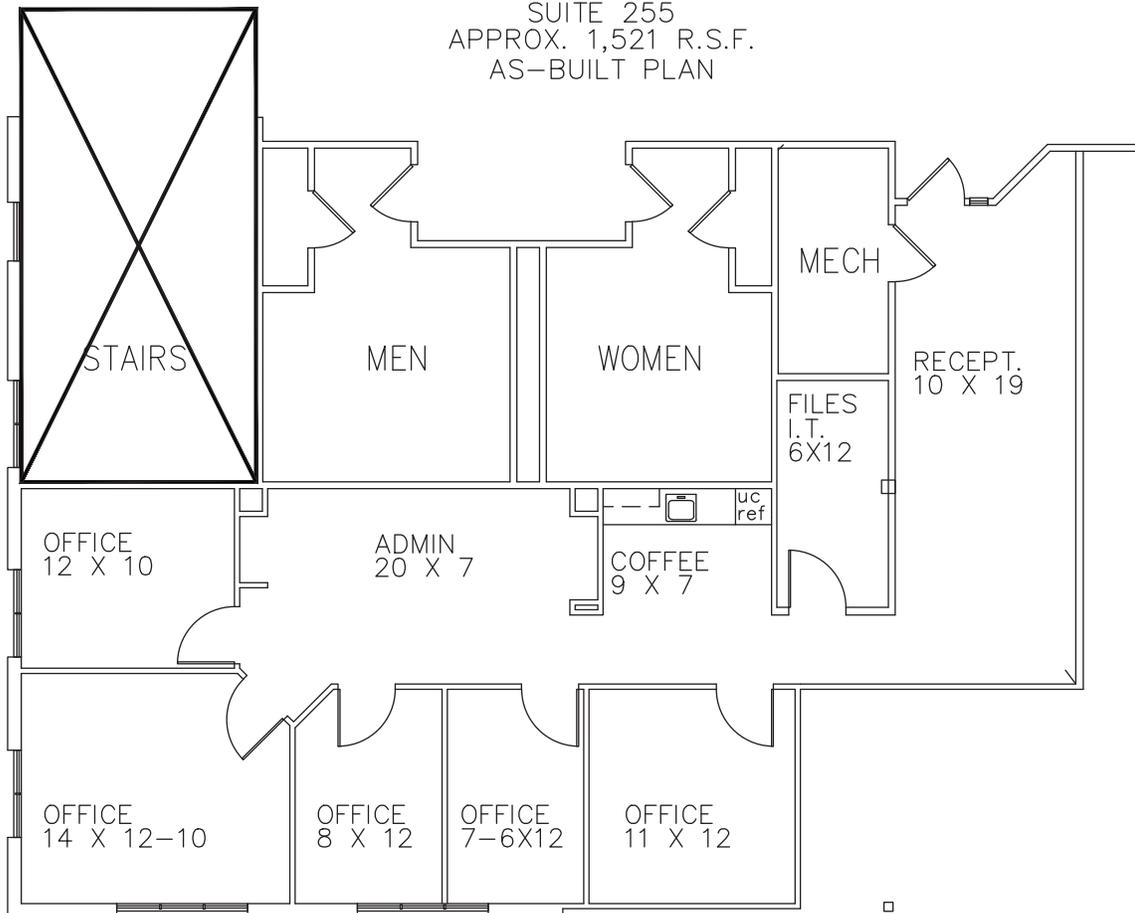

Beachum & Poeser

MANAGEMENT CORPORATION

CALL:

BILL BEACHUM
 248-647-7500

(PLAN NOT TO SCALE)