


GEORGETOWNE EXECUTIVE OFFICES

31700 TELEGRAPH ROAD – BINGHAM FARMS, MI
AVAILABLE FOR LEASE

AS-BUILT
SUITE #235
SECOND FLOOR
APPROX. 1,103 RSF.
1-22-2021

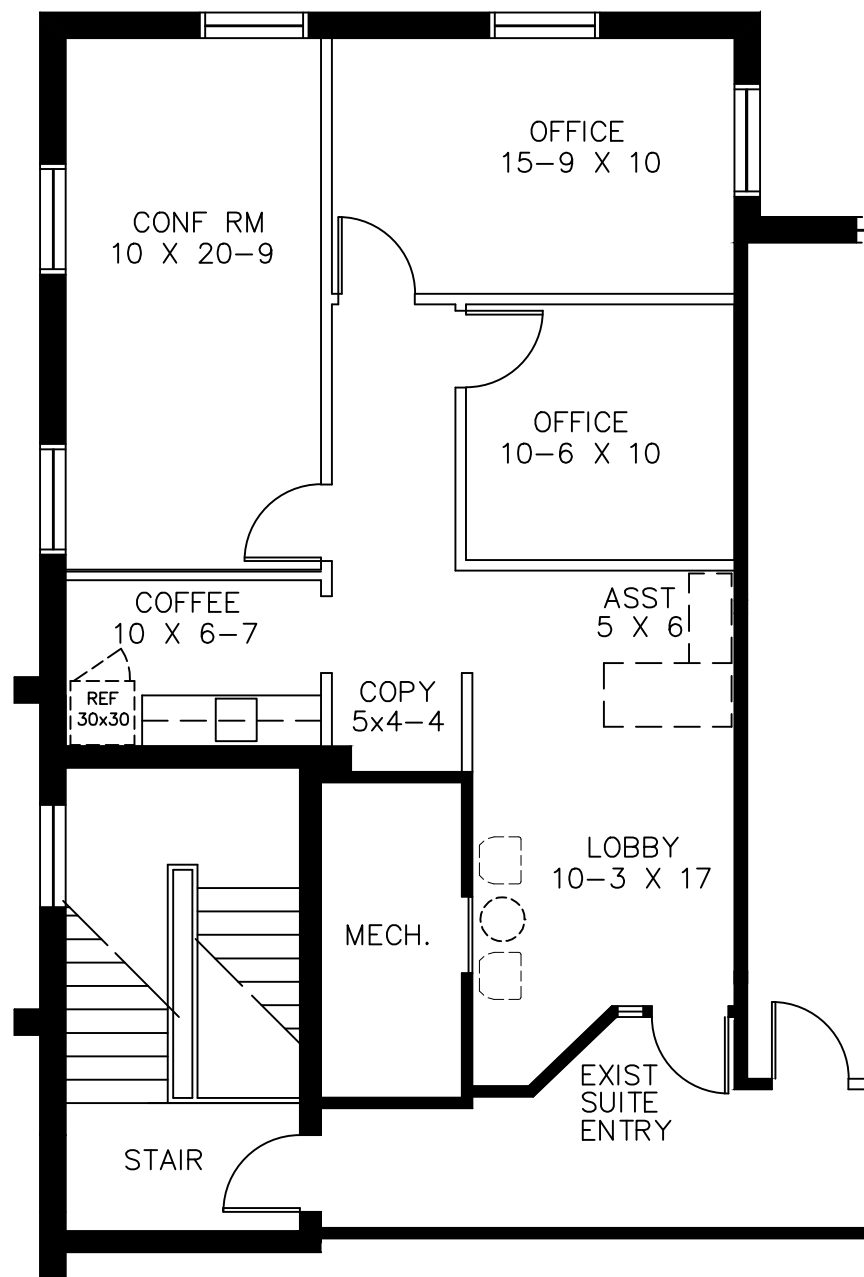

Beachum & Poeser

DEVELOPMENT & MANAGEMENT CORPORATION

CALL:
BILL BEACHUM
248-647-7500