



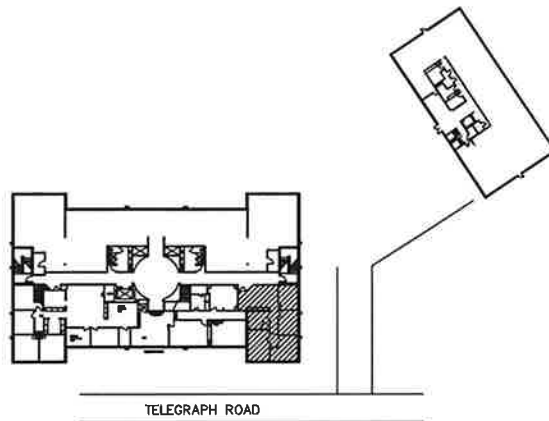

GEORGETOWNE EXECUTIVE OFFICES 31700 TELEGRAPH ROAD — BINGHAM FARMS, MI

SUITE # 265
 AS-BUILT
 APPROX. 1,333 RSF.
 5-14-2021

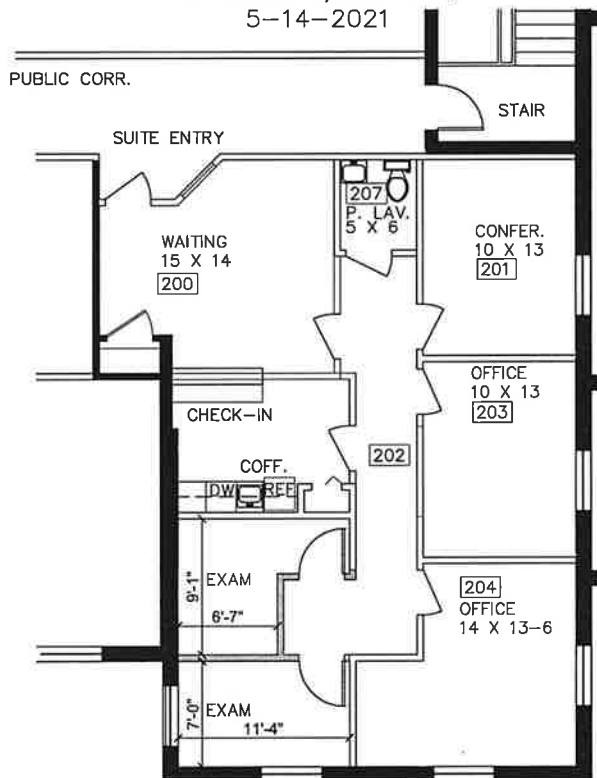

Beachum & Roeser

DEVELOPMENT & MANAGEMENT CORPORATION

CALL:
 BILL BEACHUM
 248-647-7500