


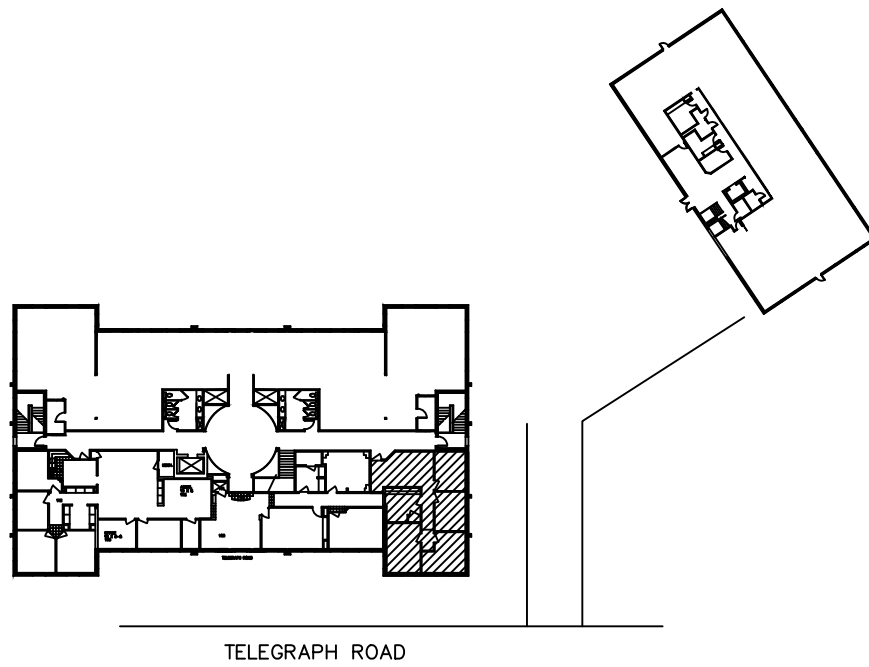


GEORGETOWNE EXECUTIVE OFFICES

31700 TELEGRAPH ROAD — BINGHAM FARMS, MI
AVAILABLE FOR LEASE

SUITE # 265

AS-BUILT

APPROX. 1,333 RSF.

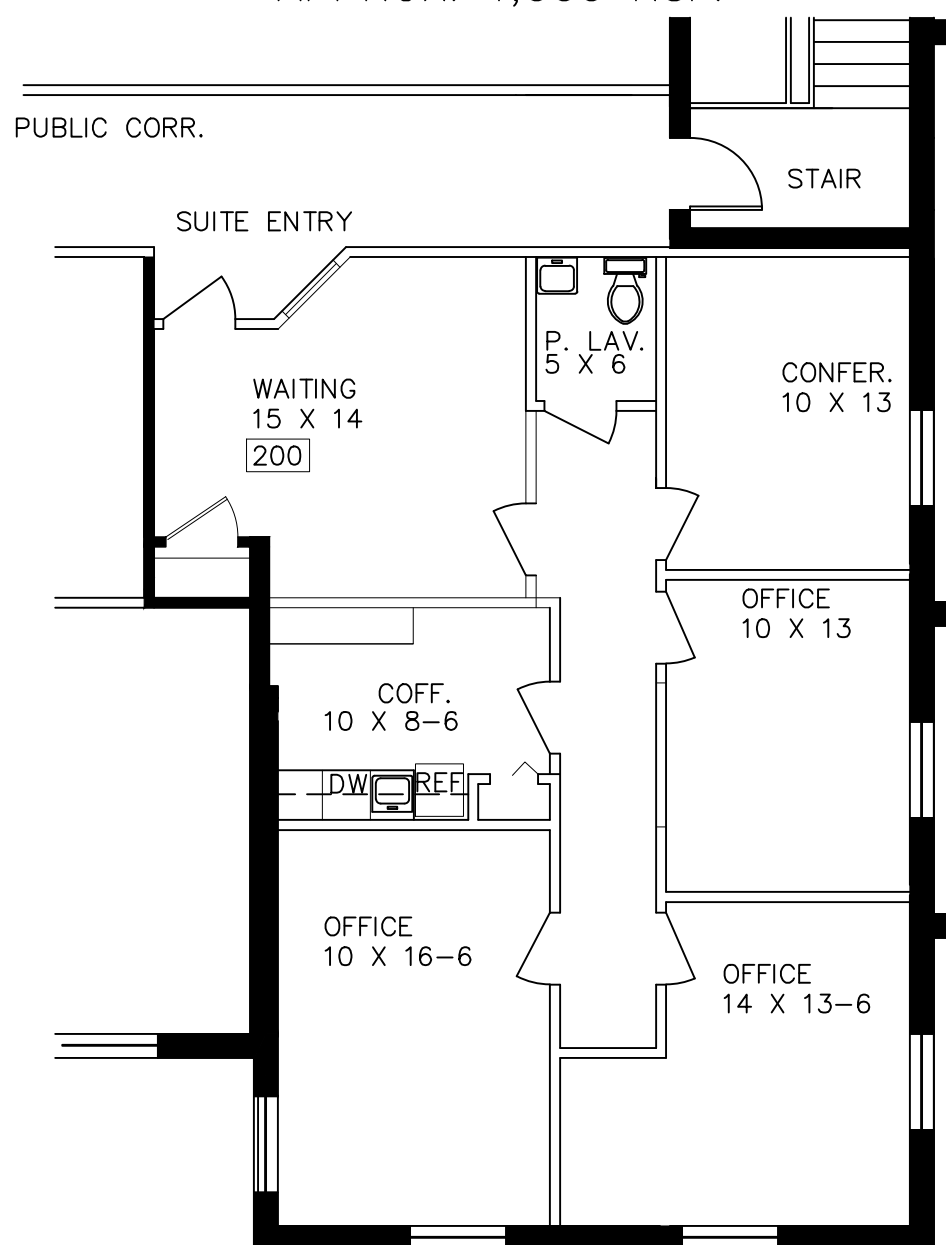

Beachum & Poeser

DEVELOPMENT & MANAGEMENT CORPORATION

CALL:
BILL BEACHUM
248-647-7500