


GOVERNORS PLACE

33 BLOOMFIELD HILLS PARKWAY

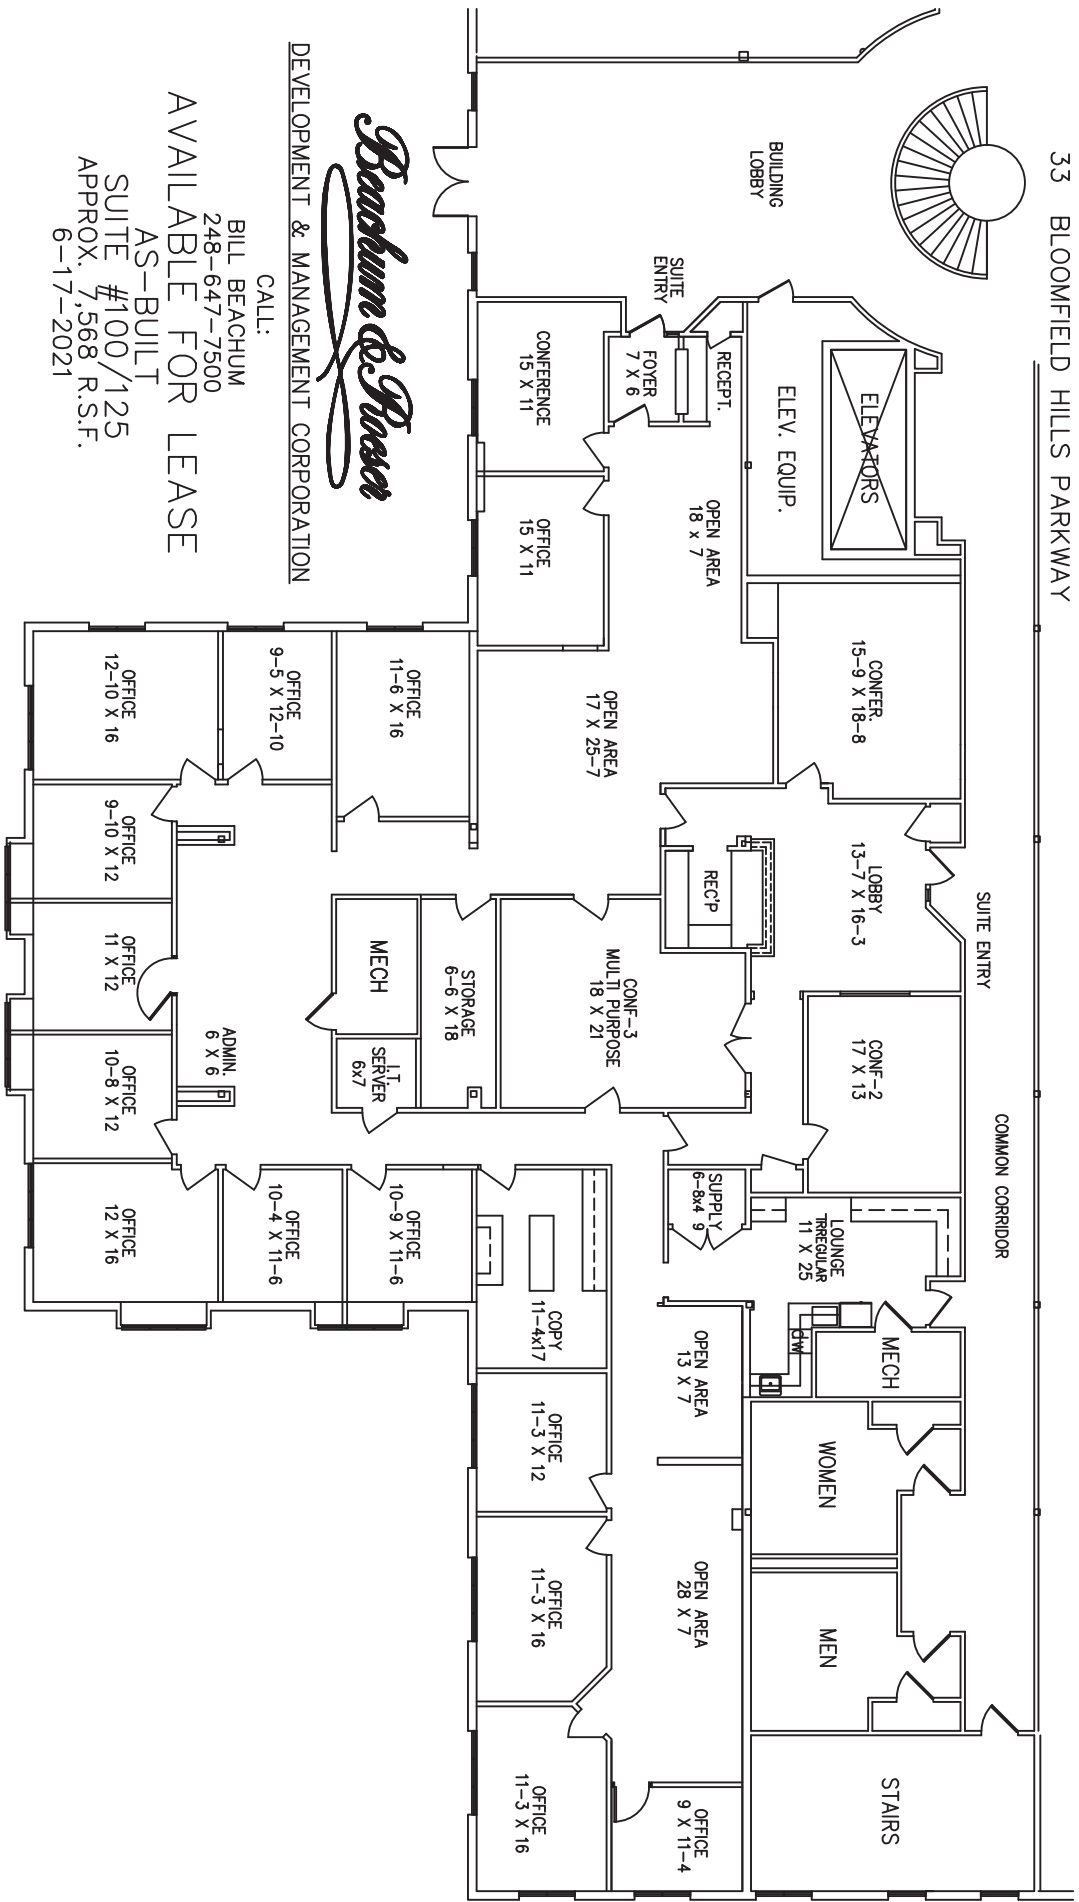

DEVELOPMENT & MANAGEMENT CORPORATION

CALL:

BILL BEACHUM
248-647-7500

AVAILABLE FOR LEASE

AS-BUILT
SUITE #100/125
APPROX. 7,568 R.S.F.
6-17-2021