


GOVERNORS PLACE

33 BLOOMFIELD HILLS PARKWAY
 BLOOMFIELD HILLS, MI.
 SUITE 255
 APPROX. 1,521 R.S.F.
 AS-BUILT PLAN

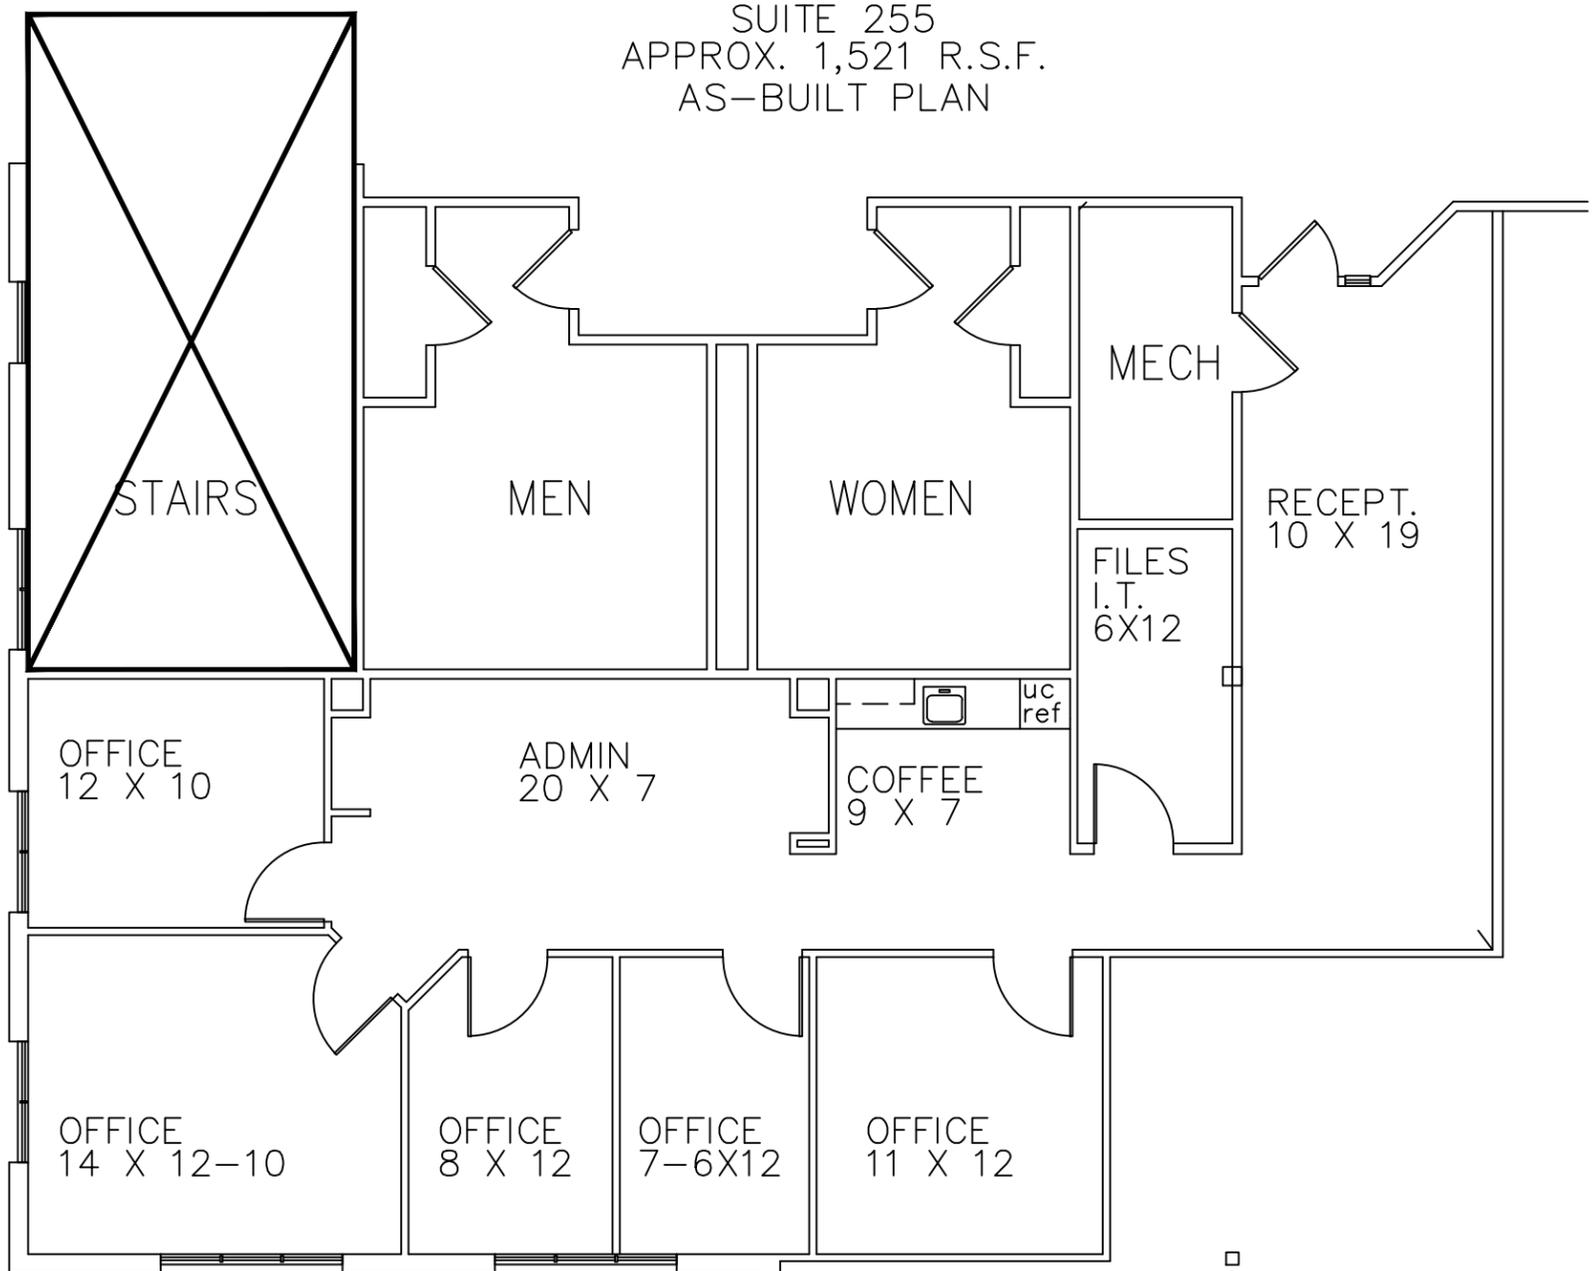

Beachum & Poeser

MANAGEMENT CORPORATION

CALL:

BILL BEACHUM
 248-647-7500
 (PLAN NOT TO SCALE)