


HERITAGE SQUARE

1719-1779 WEST BIG BEAVER ROAD - TROY, MI.

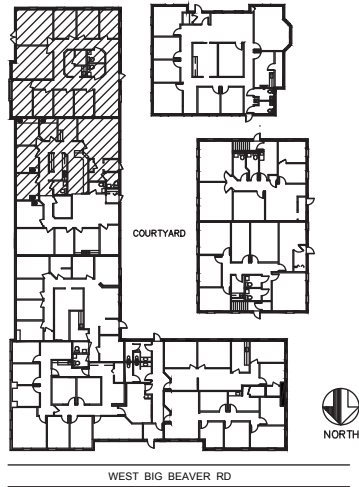

1779


AVAILABLE FOR LEASE
SUITE AS-BUILT
APPROX. 3,965 SQ.FT.
TOTAL - MAY DIVIDE

1779

AVAILABLE FOR LEASE
AS-BUILT
EXISTING:
APPROX. 2,402 SQ.FT.

1778

AVAILABLE FOR LEASE
AS-BUILT
EXISTING:
APPROX. 1,563 SQ.FT.

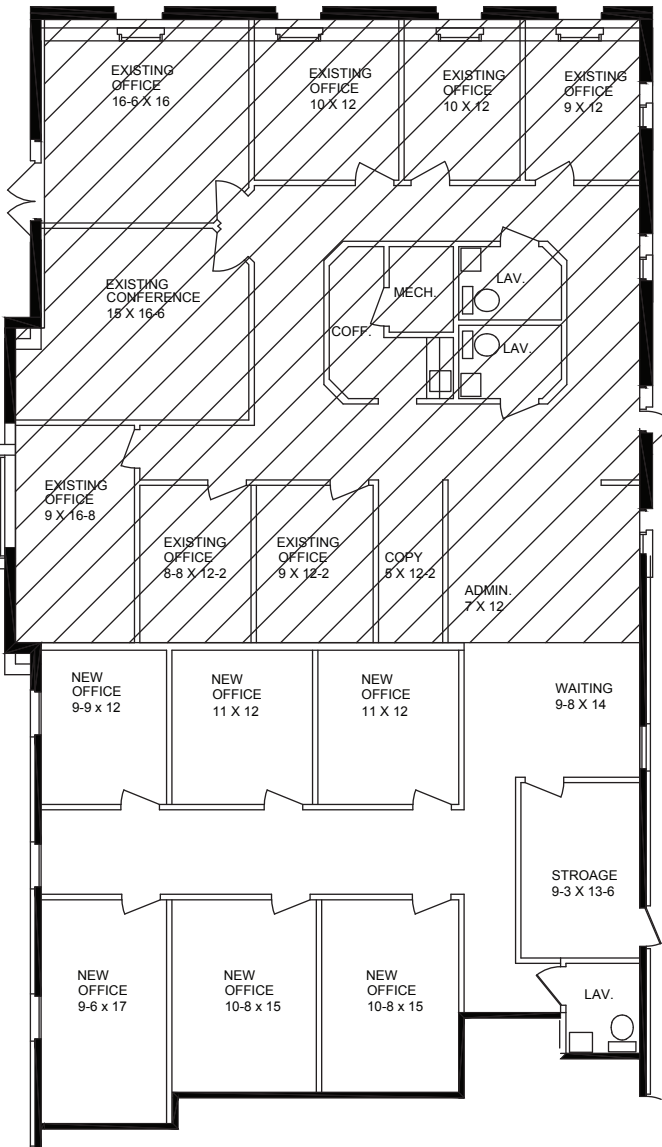

Beachum & Poeser

MANAGEMENT & DEVELOPMENT CORPORATION

CALL:
BILL BEACHUM
248-647-7500