


HERITAGE SQUARE

1771 WEST BIG BEAVER, TROY

AVAILABLE FOR LEASE
APPROX 2,480 SQ. FT.
AS-BUILT FLOOR PLAN

12-1-2020

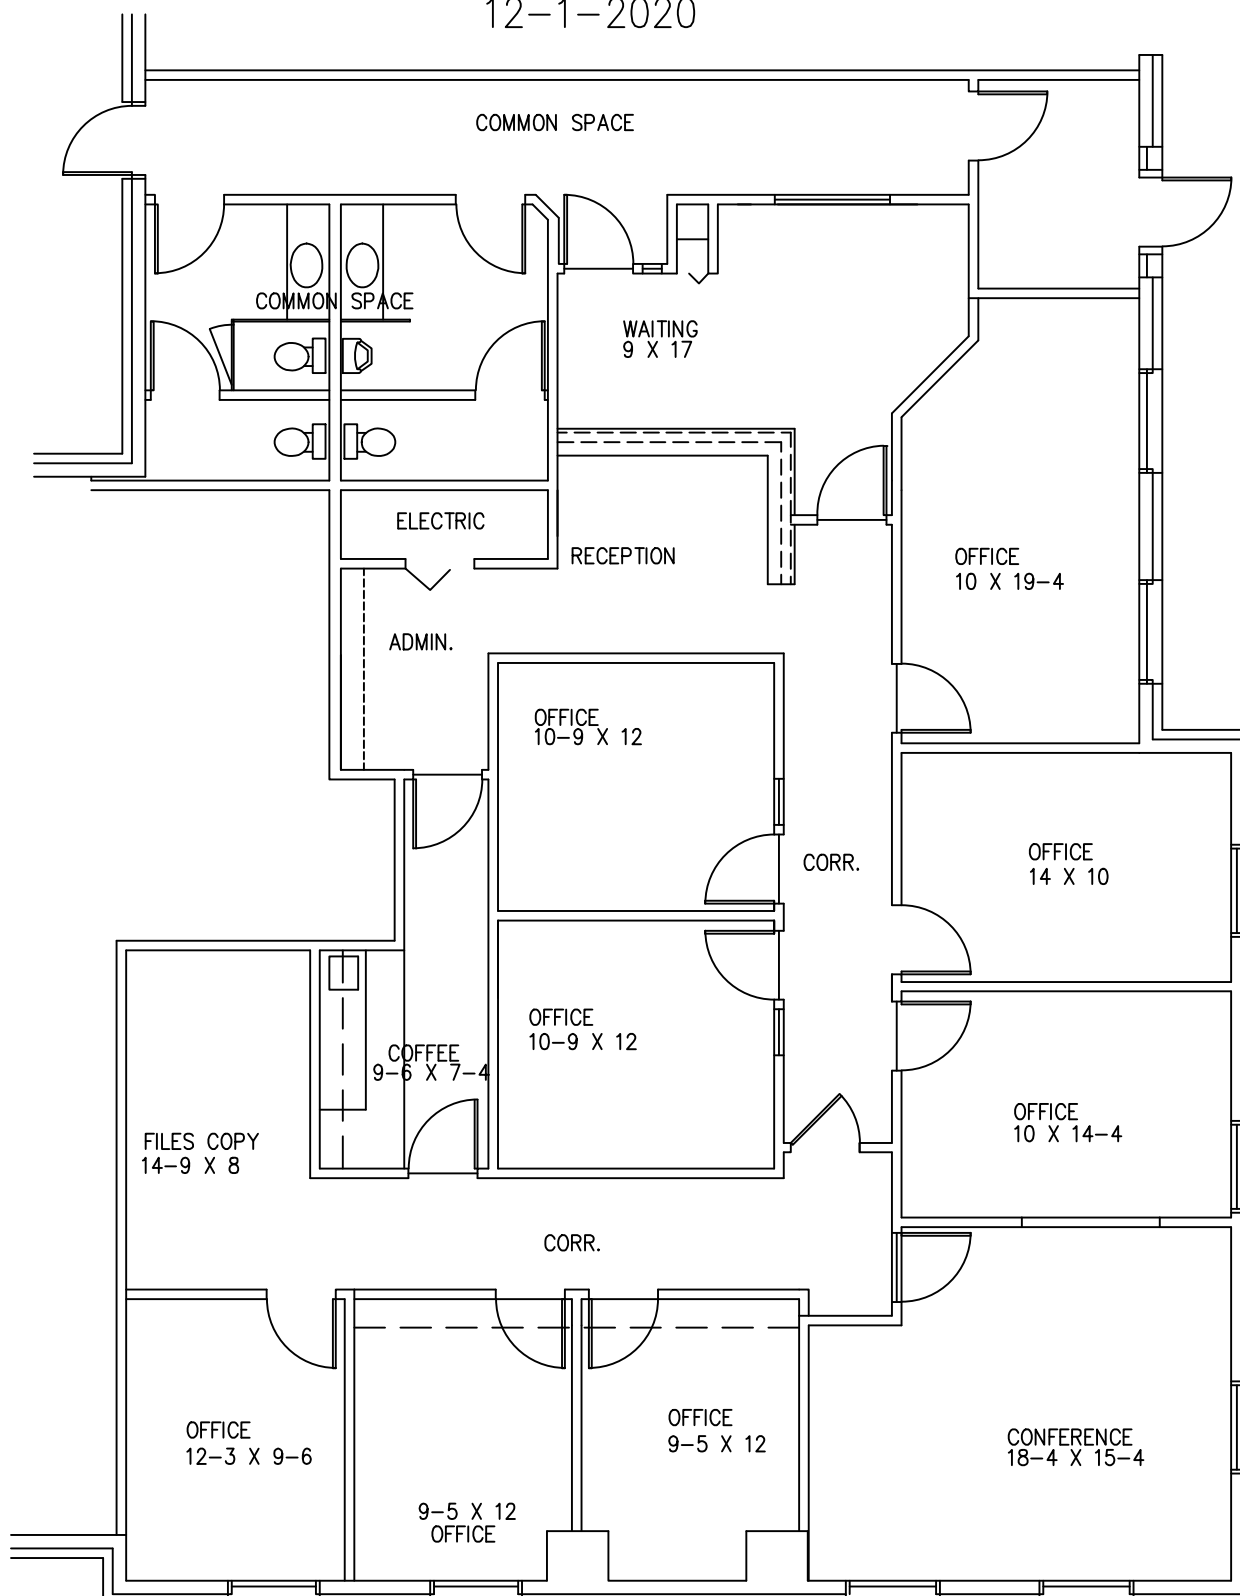

PARTIAL FLOOR PLAN

BEACHUM & ROESER
HERITAGE SQUARE
FARM BUREAU INSURANCE
EXISTING PLAN

SCALE: 1/8" = 1'-0"

Beachum & Roesser

DEVELOPMENT AND MANAGEMENT CORPORATION

CALL:
BILL BEACHUM
248-647-7500