



HERITAGE SQUARE

1719-1779 WEST BIG BEAVER ROAD - TROY, MI.

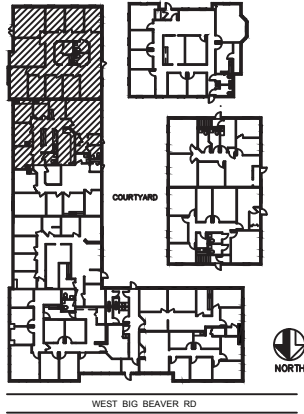

1779

AVAILABLE FOR LEASE
SUITE AS-BUILT
APPROX. 3,965 SQ.FT.
10-19-21

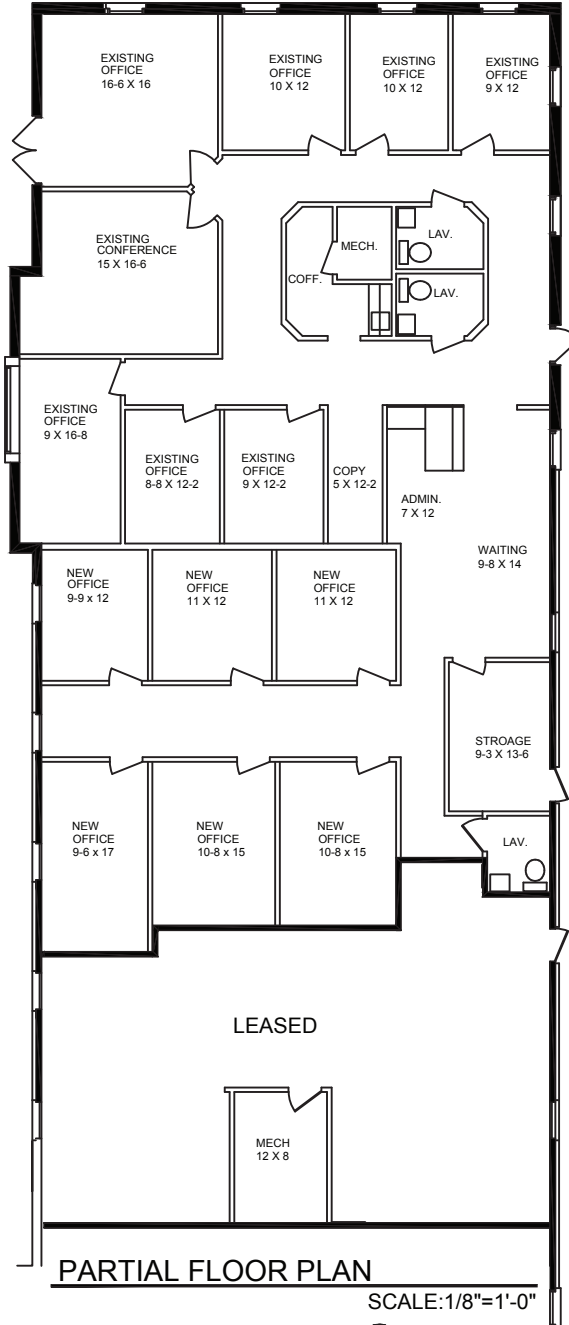

PARTIAL FLOOR PLAN

SCALE: 1/8" = 1'-0"

Beachum & Pioser

MANAGEMENT & DEVELOPMENT CORPORATION

CALL:
BILL BEACHUM
248-647-7500