


1601 BRIARWOOD CIRCLE - ANN ARBOR, MI.

**BEACHUM AND ROESER DEVELOPMENT
WILLIAMSBURG VII - ANN ARBOR**

AVAILABLE FOR LEASE
AS-BUILT
SUITE 450
APPROX. 2,043 R.S.F.
10-7-2021

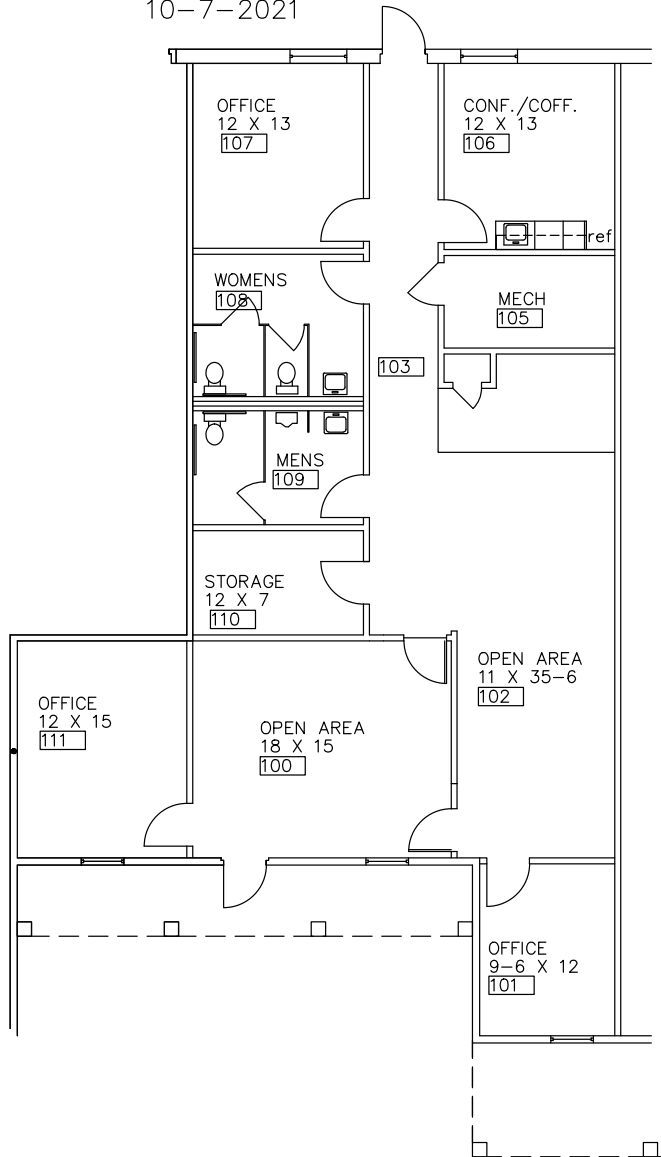

PARTIAL FIRST FLOOR PLAN

SCALE: 1/8" = 1'-0"



DEVELOPMENT & MANAGEMENT CORPORATION

CALL:
BILL BEACHUM
248-647-7500